

1

POLE LIST:



POLE No.	POLE SIZE (Lgth & Top Dia)
OP47	16.0m x 240mm (PAIR)
OP46	15.0m x 230mm (PAIR)
OP15	14.0m x 230mm (PAIR)
OP10	14.0m x 220mm (PAIR)

2

3

4

5

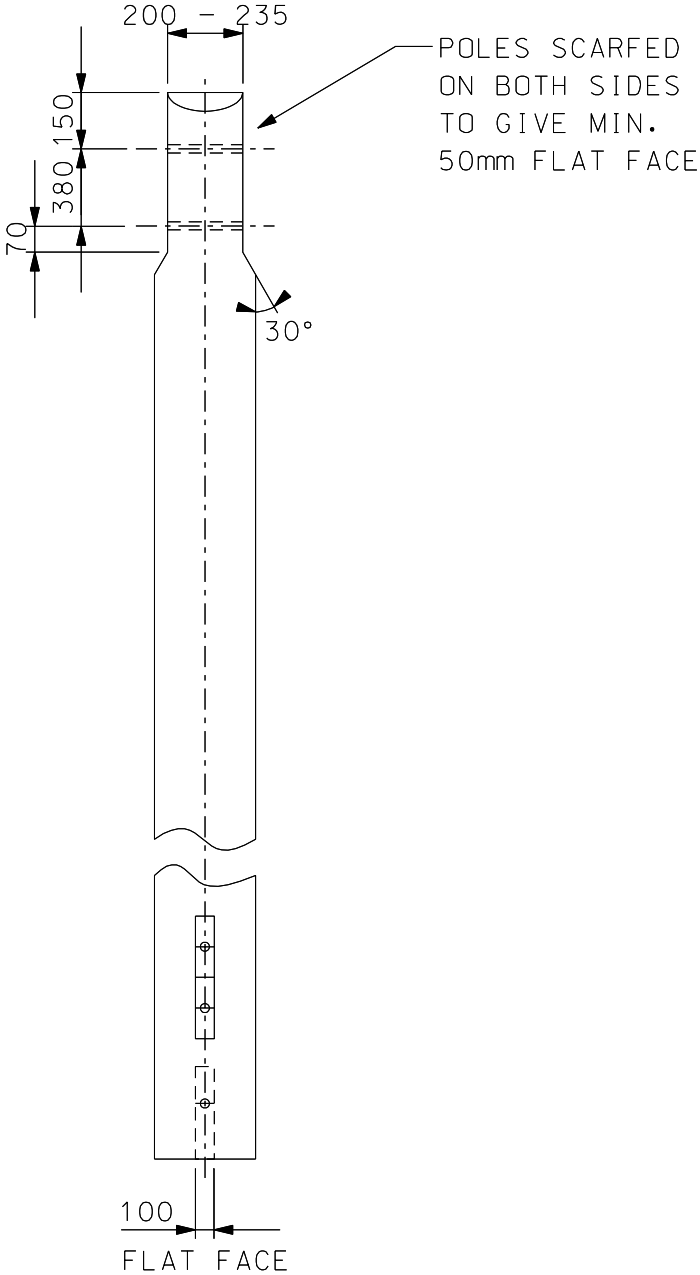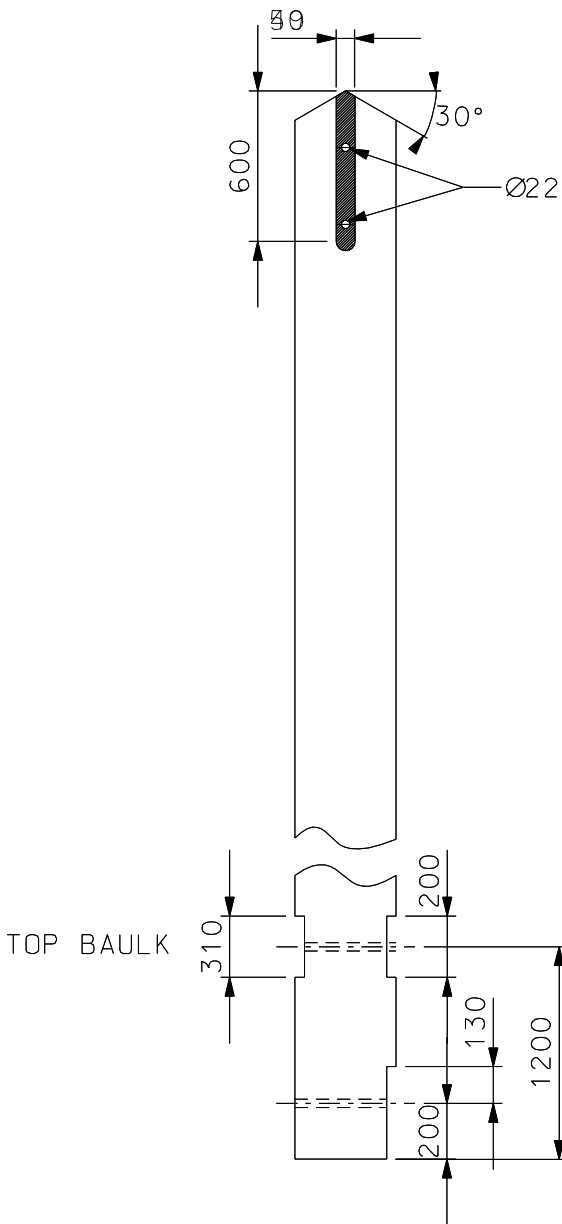

NOTES
ALL POLES TO COMPLY WITH THE
REQUIREMENT OF BS1990 AND
E.A.T.S. 43-50

WOODPOLE AND BAULK TO BE
CREOSOTED TO E.A.T.S. 43-88

REV	DATE	NAME	CHK'D	APP'D	REMARKS
0	22/7/03	LJE	AJC	RF	ORIGINAL ISSUE
A	05/8/03	AJC	RF	RF	POLE SIZES AMENDED TO SHOW TOP DIA.
B	04/9/03	AJC	AC	RF	ISSUED FOR CONSTRUCTION.
C	01/4/04	AJC	AC	RF	AS BUILT



AMEC CAPITAL PROJECTS-POWER LIMITED 143 BARKBY ROAD, LEICESTER, LE49LG
Telephone: (0116) 2460900 Fax: (0116) 2460 032

PROJECT
EME
WILLINGTON - BURTON
132KV OP OHL
AP1 DESIGN

This drawing is confidential and the copyright of Amec Power Limited.
It must not be copied or passed to a third party without written consent.

TITLE
TERMINAL & 30-60 DEGREE ANGLE
'H' WOODPOLE SCARFING &
DRILLING DETAILS

DRG. No.	SHT No.	No. of SHTS	Scale
30514/2499.C	2	3	