
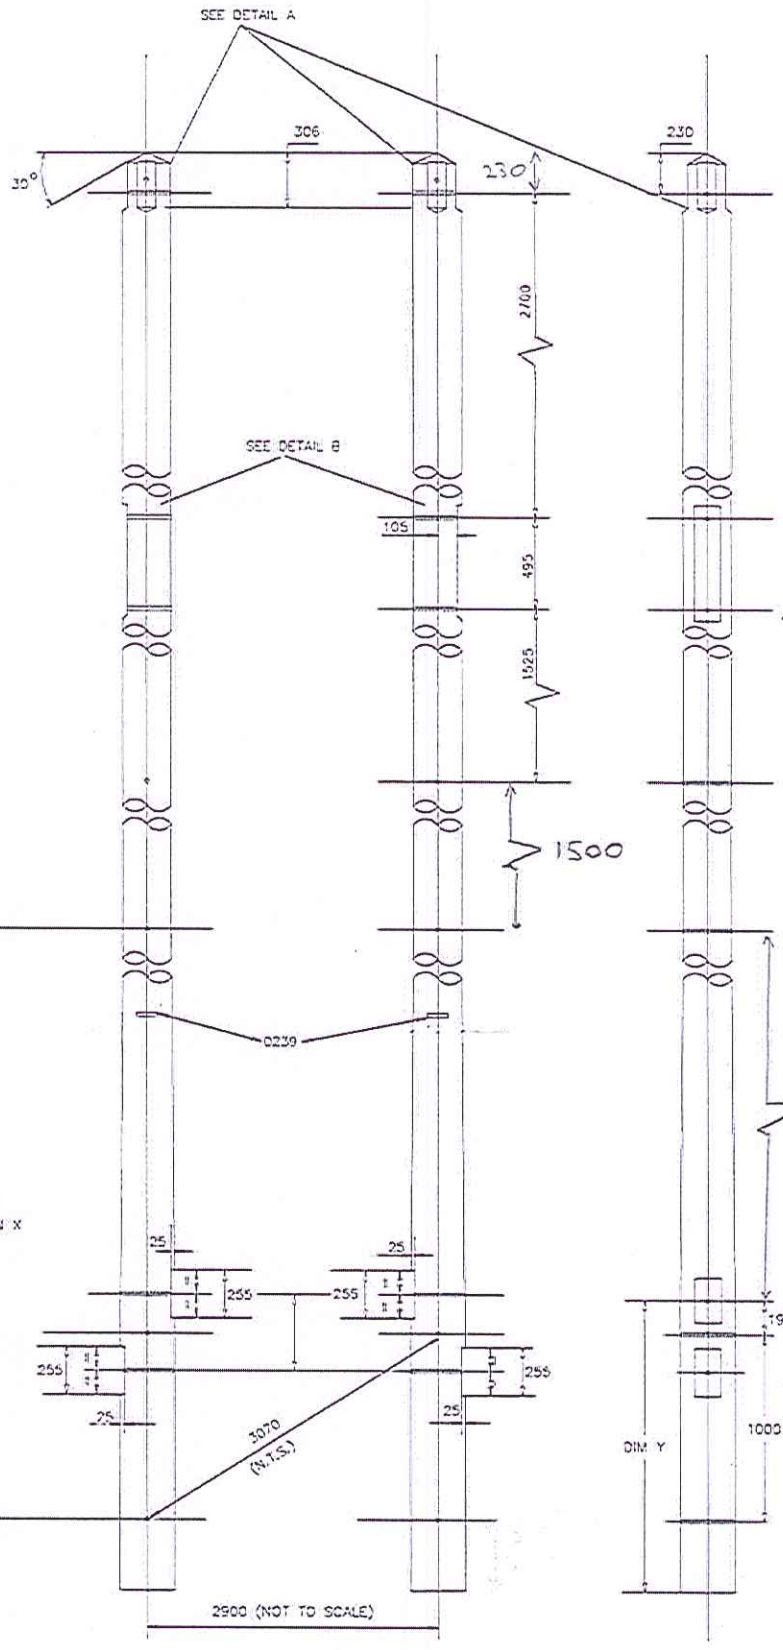


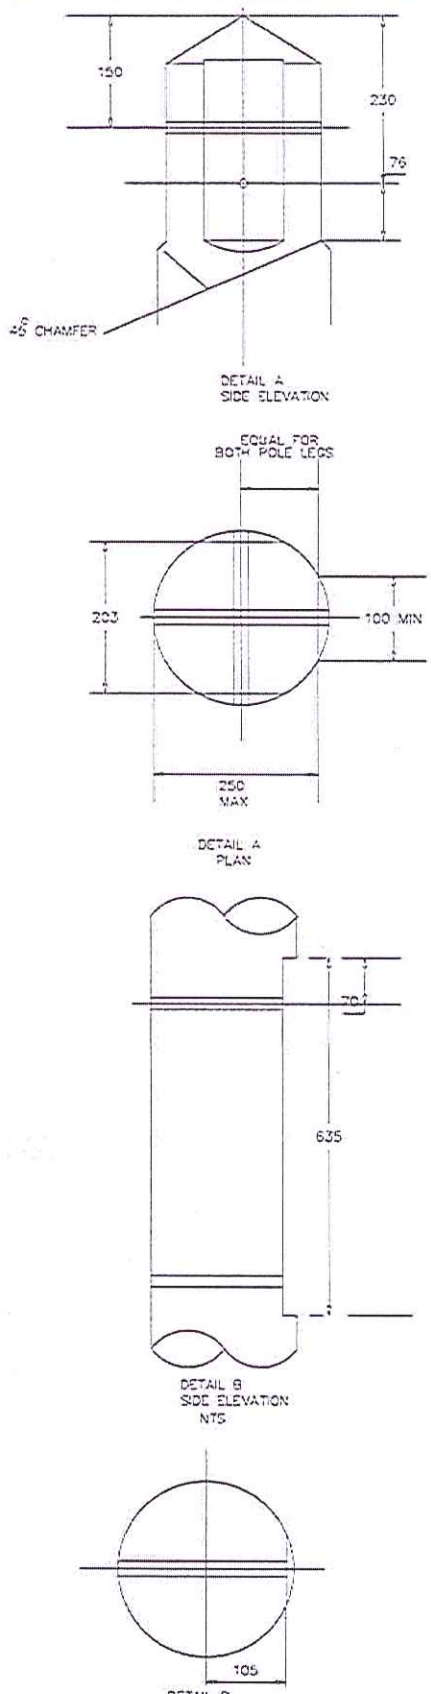

NOTES:

1. POLE LEGS TO BE MATCHED. POLE TOP MINIMUM DIAMETER BEFORE FABRICATION STOUT – 230mm
2. ALL HOLES TO BE 22mm DIA. DRILLED AT RIGHT ANGLES TO VERTICAL CENTRE LINE OF POLE. ALL DRILLING AND CUTTING TO BE DONE STRICTLY TO TEMPLATE PRIOR TO CREASOTING.
3. POLE BUTTS TO CUT AT RIGHT ANGLES TO AXIS OF POLE.
4. POLE LEGS TO BE NOTCHED AND DRILLED FOR 250 X 125 WOOD BAULKS AS SHOWN
5. POLE TO BE SUPPLIED WITH 4 – 1300 X 250 X 125 BAULKS TO DRG NO 1 00 043 9130 TYPE 2 CUT FROM THE SQUARE AND 4 – M20 GALVANISED BOLTS EACH WITH 1 FLAT AND 1 CURVED GALVANISED WASHER TO DRG NOS 1 00 043 9604 AND 9605 RESPECTIVELY.
6. HOLES NOT REQUIRED FOR PARTICULAR APPLICATIONS WILL BE PLUGGED ON SITE

ALL DIMENSIONS SHOWN ARE IN MILLIMETRES UNLESS OTHERWISE STATED

POLE LENGTH	NEW	DIM X	DIM Y
~~12.0m~~	~~5040~~	5655	1700
13.0m	6040	5655	1700
14.0m	7040	7655	1700
15.0m	8040	8655	1700
16.0m	9040	9655	1900

NEDL

NEDL, Manor House, Station Road, Houghton le Spring, DH4 7LA.

66KV SINGLE CIRCUIT LINES
DRILLING AND SCARFING FOR TERMINAL SUPPORT
WITH SURGE ARRESTERS – 1173 SHEET 4

Prepared by	Drg.No.	Sheet No.
C.T.	1 09 123 1173	5
Checked: C.S. / Date issued: AUG 95	Mod.	Revised / Scale 1:20 & 1:5

MODIFIED 17-06-15 JH-BRUSL 001